


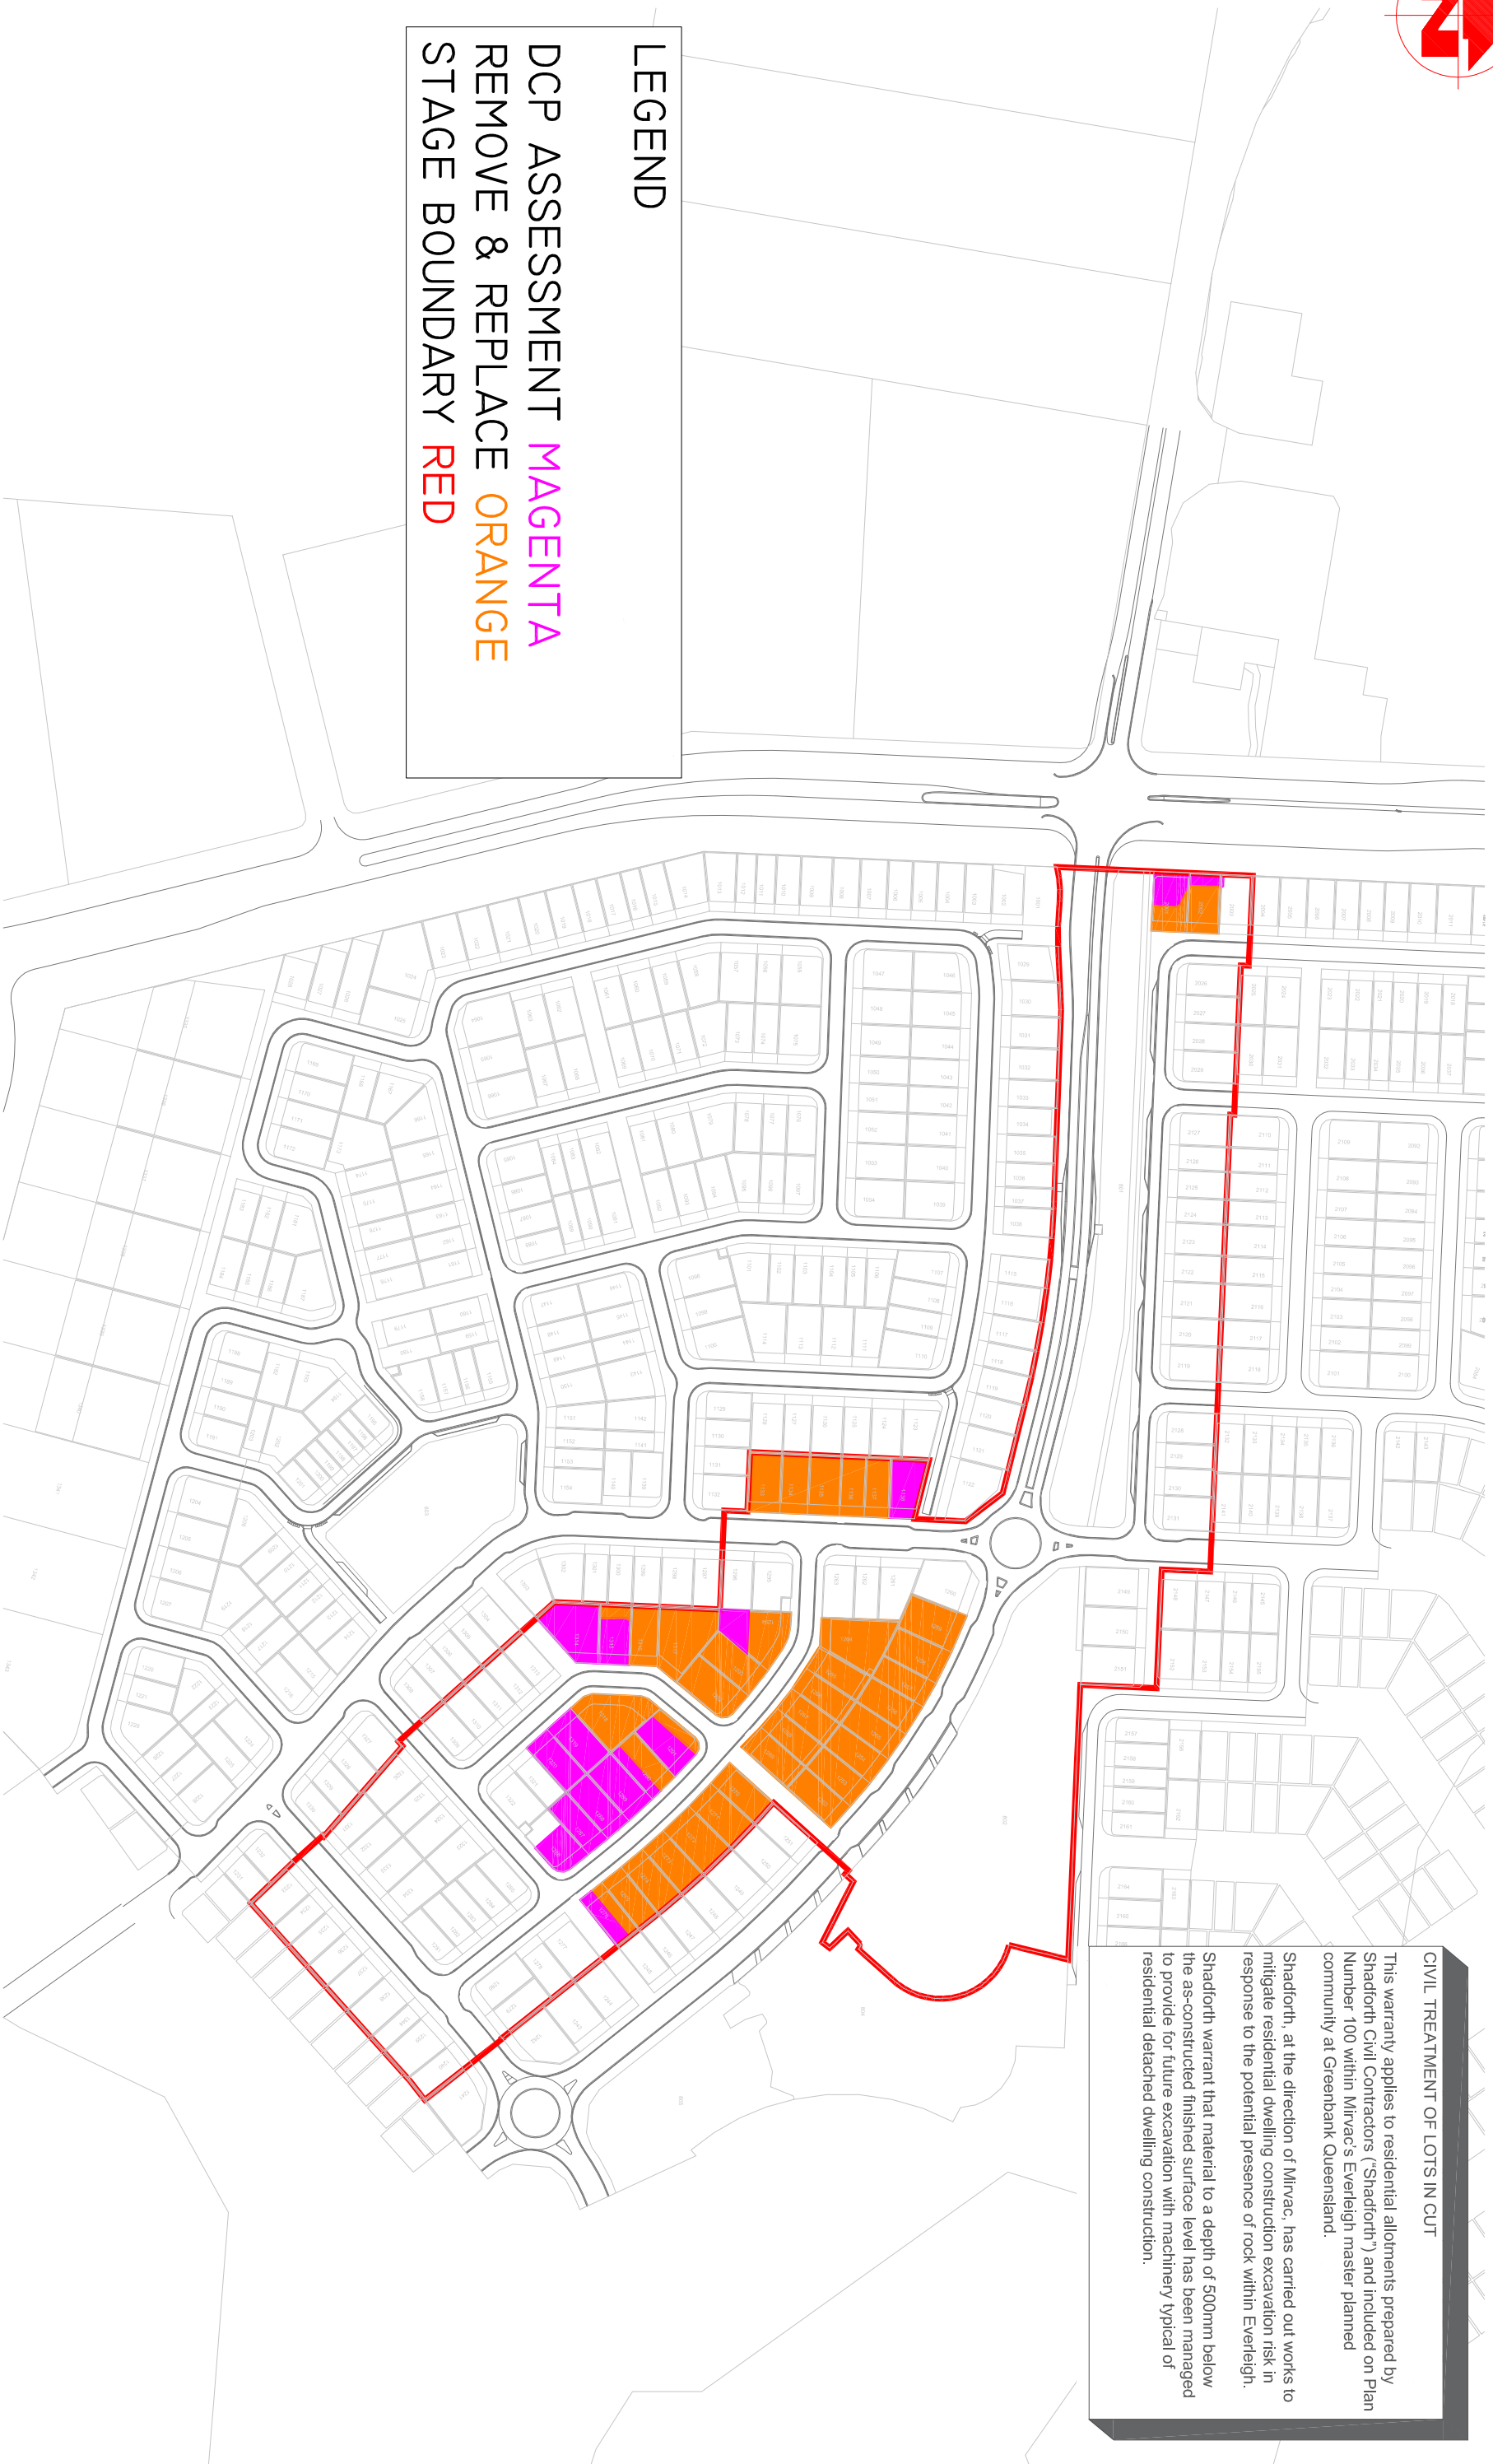

LEGEND

DCP ASSESSMENT **MAGENTA**
 REMOVE & REPLACE **ORANGE**
 STAGE BOUNDARY **RED**



CIVIL TREATMENT OF LOTS IN CUT

This warranty applies to residential allotments prepared by Shadforth Civil Contractors ("Shadforth") and included on Plan Number 100 within Mirvac's Everleigh master planned community at Greenbank Queensland.

Shadforth, at the direction of Mirvac, has carried out works to mitigate residential dwelling construction excavation risk in response to the potential presence of rock within Everleigh.

Shadforth warrant that material to a depth of 500mm below the as-constructed finished surface level has been managed to provide for future excavation with machinery typical of residential detached dwelling construction.

ISSUE DATE	AUTHOR	COMMENTS



shadforth

99 Sandalwood Lane, Forest Glen QLD 4556
 P: 07 5438 3300 ▶ F: 07 5438 3388 ▶ E: admin@shadcivil.com.au

DRAWING TITLE		ASSOCIATE CONSULTANT	
LOT TREATMENT FOR LOTS IN CUT		-	
CLIENT	MIRVAC	LOCAL GOVERNMENT	-
PROJECT	EVERLEIGH PRECINCT 1.1	SCALE	-
DATE		DATE	
LEVEL ORIGIN		LEVEL ORIGIN	
CONTOUR INTERVAL		CONTOUR INTERVAL	
DRAWN		DRAWN	
CHECKED		CHECKED	
SHEET N°		SHEET N°	
PLAN NUMBER		PLAN NUMBER	
100		100	
REVISION		REVISION	
-		-	