




CIVIL TREATMENT OF LOTS IN CUT

This warranty applies to residential allotments prepared by Shadforth Civil Contractors ("Shadforth") and included on Plan Number 100 within Mirvac's Everleigh master planned community at Greenbank Queensland.

Shadforth, at the direction of Mirvac, has carried out works to mitigate residential dwelling construction excavation risk in response to the potential presence of rock within Everleigh.

Shadforth warrant that material to a depth of 500mm below the as-constructed finished surface level has been managed to provide for future excavation with machinery typical of residential detached dwelling construction.

LEGEND
 DCP ASSESSMENT **MAGENTA**
 REMOVE & REPLACE **ORANGE**
 STAGE BOUNDARY **RED**

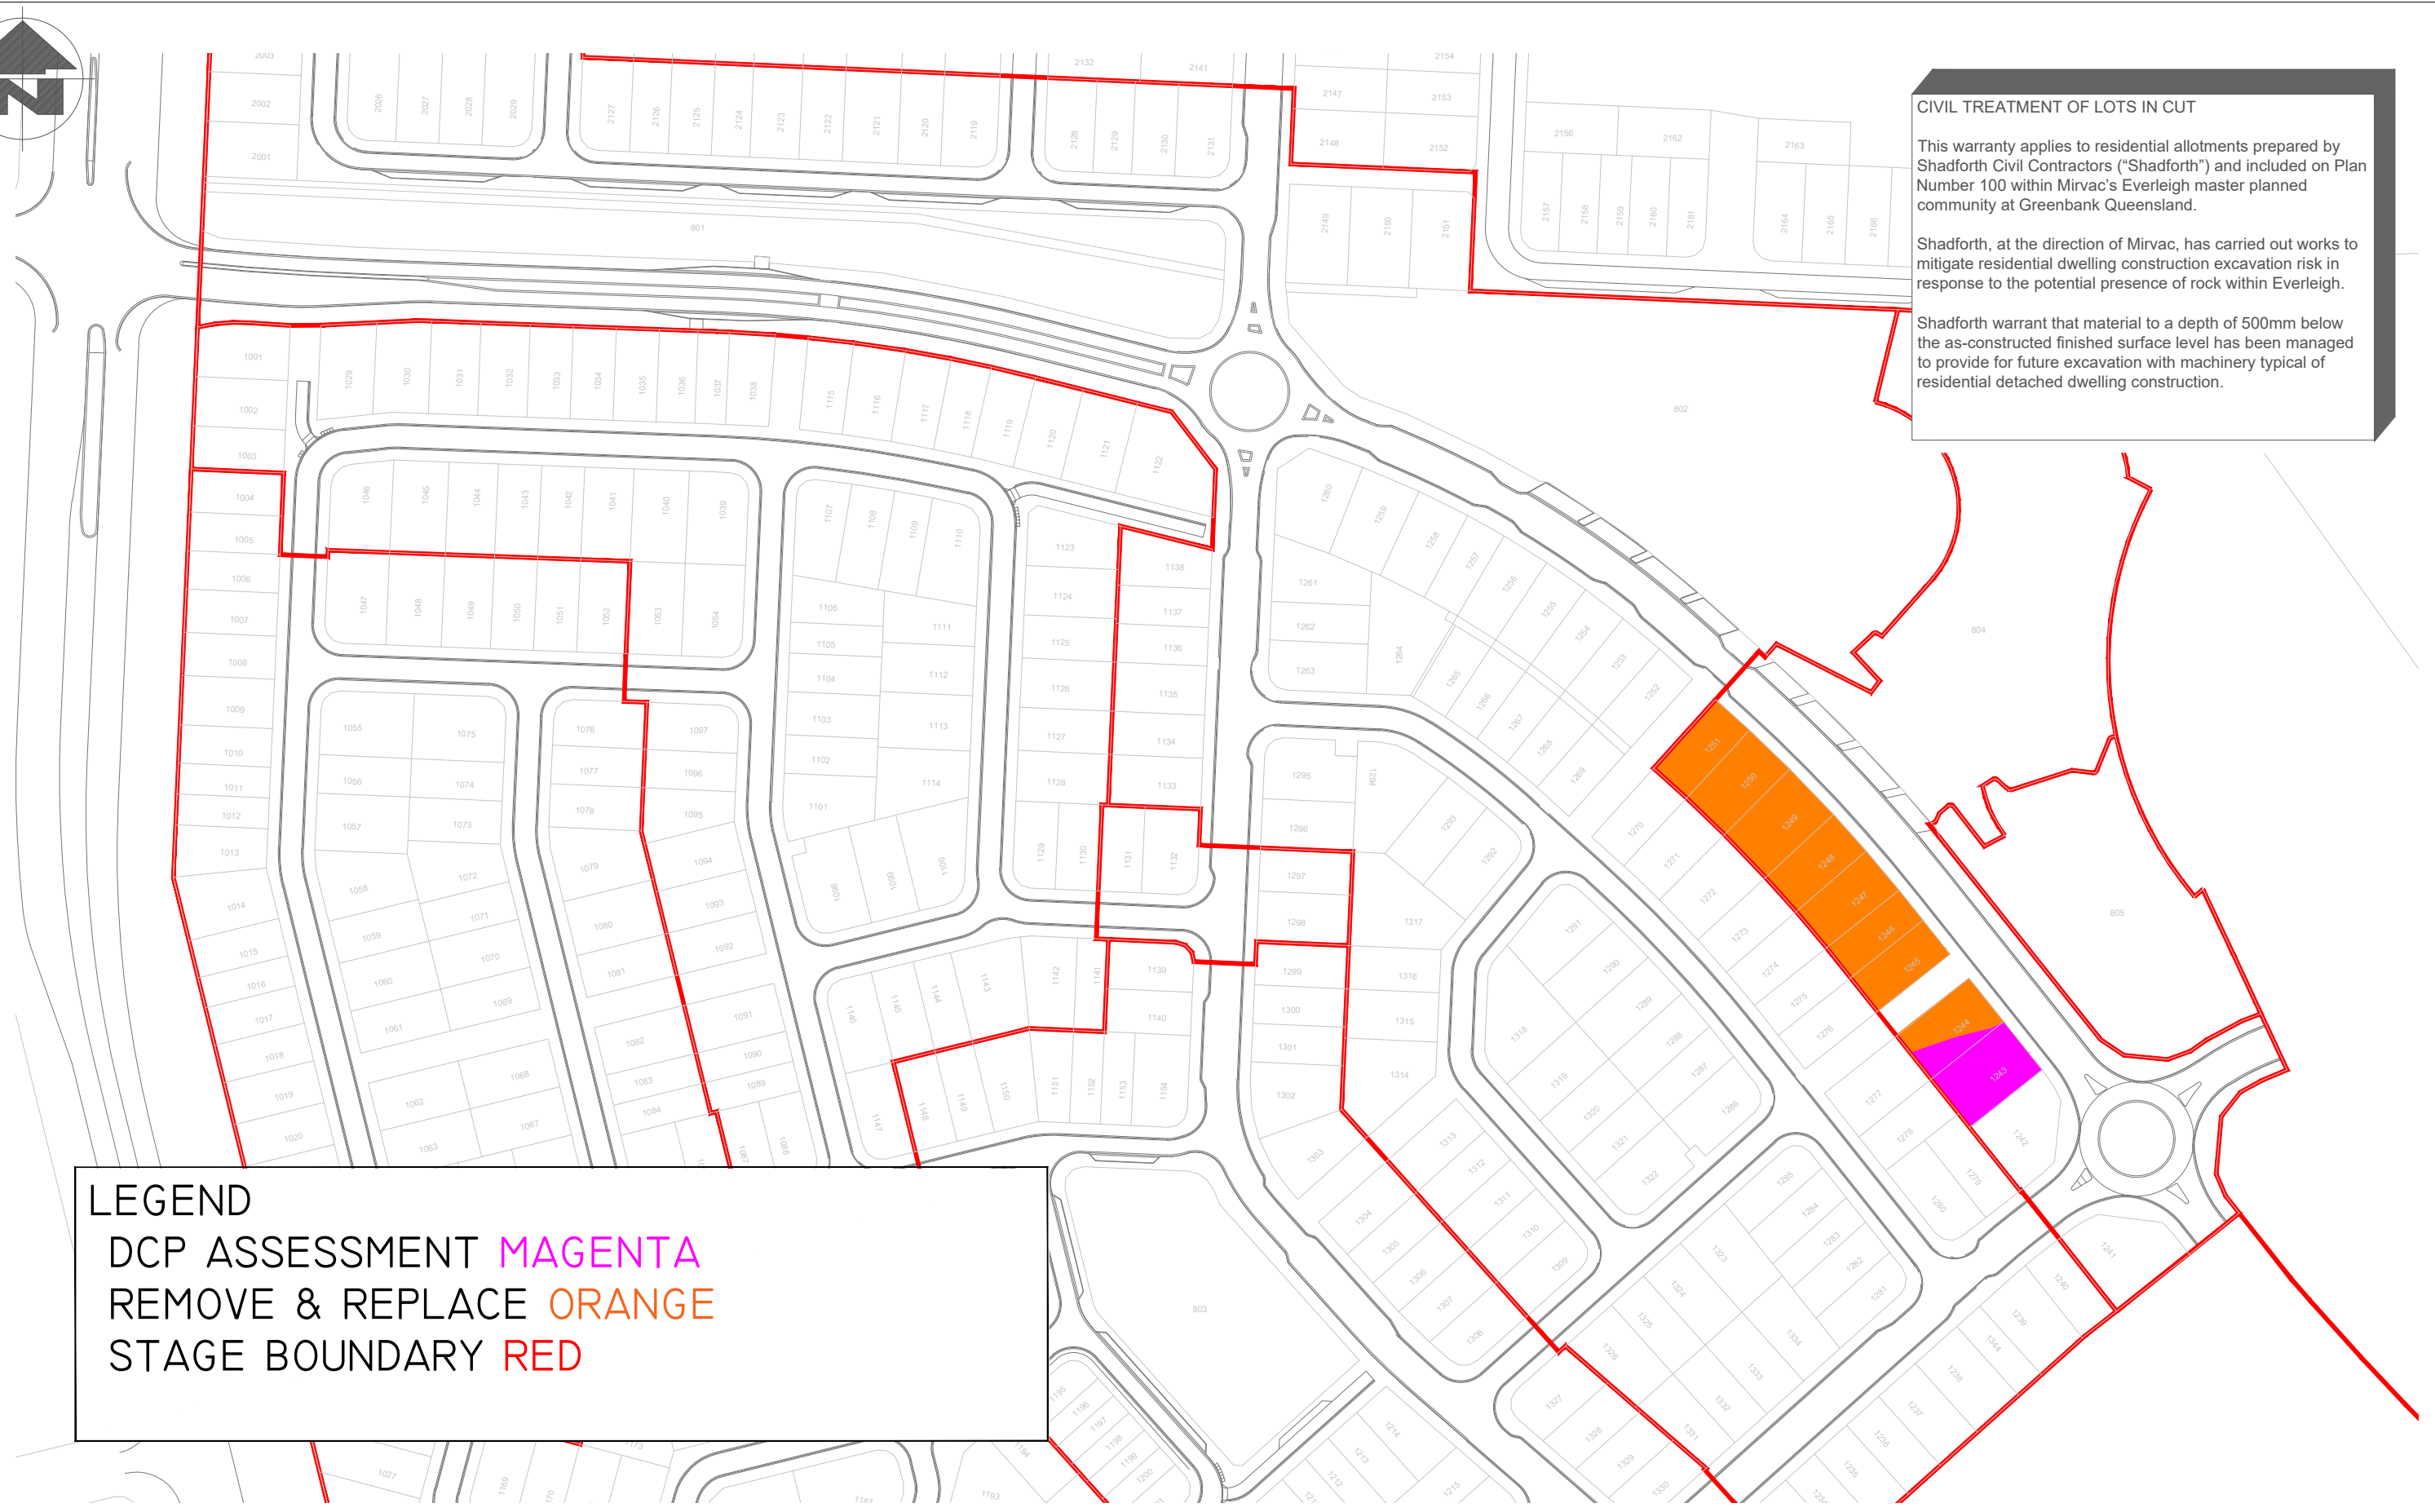

ISSUE	DATE	AUTHOR	COMMENTS



99 Sandalwood Lane, Forest Glen QLD 4556
 P: 07 5438 3300 ▶ F: 07 5438 3388 ▶ E: admin@shadcivil.com.au

DRAWING TITLE	LOT TREATMENT FOR LOTS IN CUT
CLIENT	MIRVAC
PROJECT	EVERLEIGH PRECINCT 1.5E

ASSOCIATE CONSULTANT	-
LOCAL GOVERNMENT	-
SCALE	-

DATUM	N/A
LEVEL ORIGIN	N/A
CONTOUR INTERVAL	N/A
DRAWN	MW DATE 15/10/20
CHECKED	DB DATE 15/10/20
SHEET N°	1
PLAN NUMBER	10
REVISION	-